



2

Cammell Laird & Co.

No. 1023, 1024, 1032.
and 1034.

Constructional Deck Plan.

S.S. ~~City of Capetown~~ *

LIVERPOOL.

Report No. 109742.

S.S. ~~City of Pretoria~~ PLANS TRANSFERRED
LIVERPOOL: TO SISTER VESSEL

Report No. 116106

CITY OF PRETORIA *

S.S. ~~City of Pretoria~~
266 M/M. 1160

S.S. ~~City of Pretoria~~
LIVERPOOL:

Report No. _____

W1160-0141



© 2020

Lloyd's Register
Foundation

Scale $\frac{1}{8}" = 1 \text{ Foot}$.

Bridge Deck.

File Deck.

Upper Deck.

Orlop Deck.

2nd. Deck.

T.S.S. 'CITY OF PRETORIA'

ADDITIONAL STIFFENING (PILLARING)

IN NO. 1 HOLD

APRIL 1939.

Lw. Rpt. No. 112444



© 2020

Lloyd's Register
Foundation

W1160-0127 1/2

For Enclosure to

Messrs. LLOYDS REGISTER


From **Cammell Laird & Co. Ltd., Birkenhead.**

W1160-0127 3/2





T.S.S. CITY OF PRETORIA. ADDITIONAL PILLARS IN NO 1 HOLD.

SCALE $\frac{1}{4}$ INCH \approx ONE FOOT.

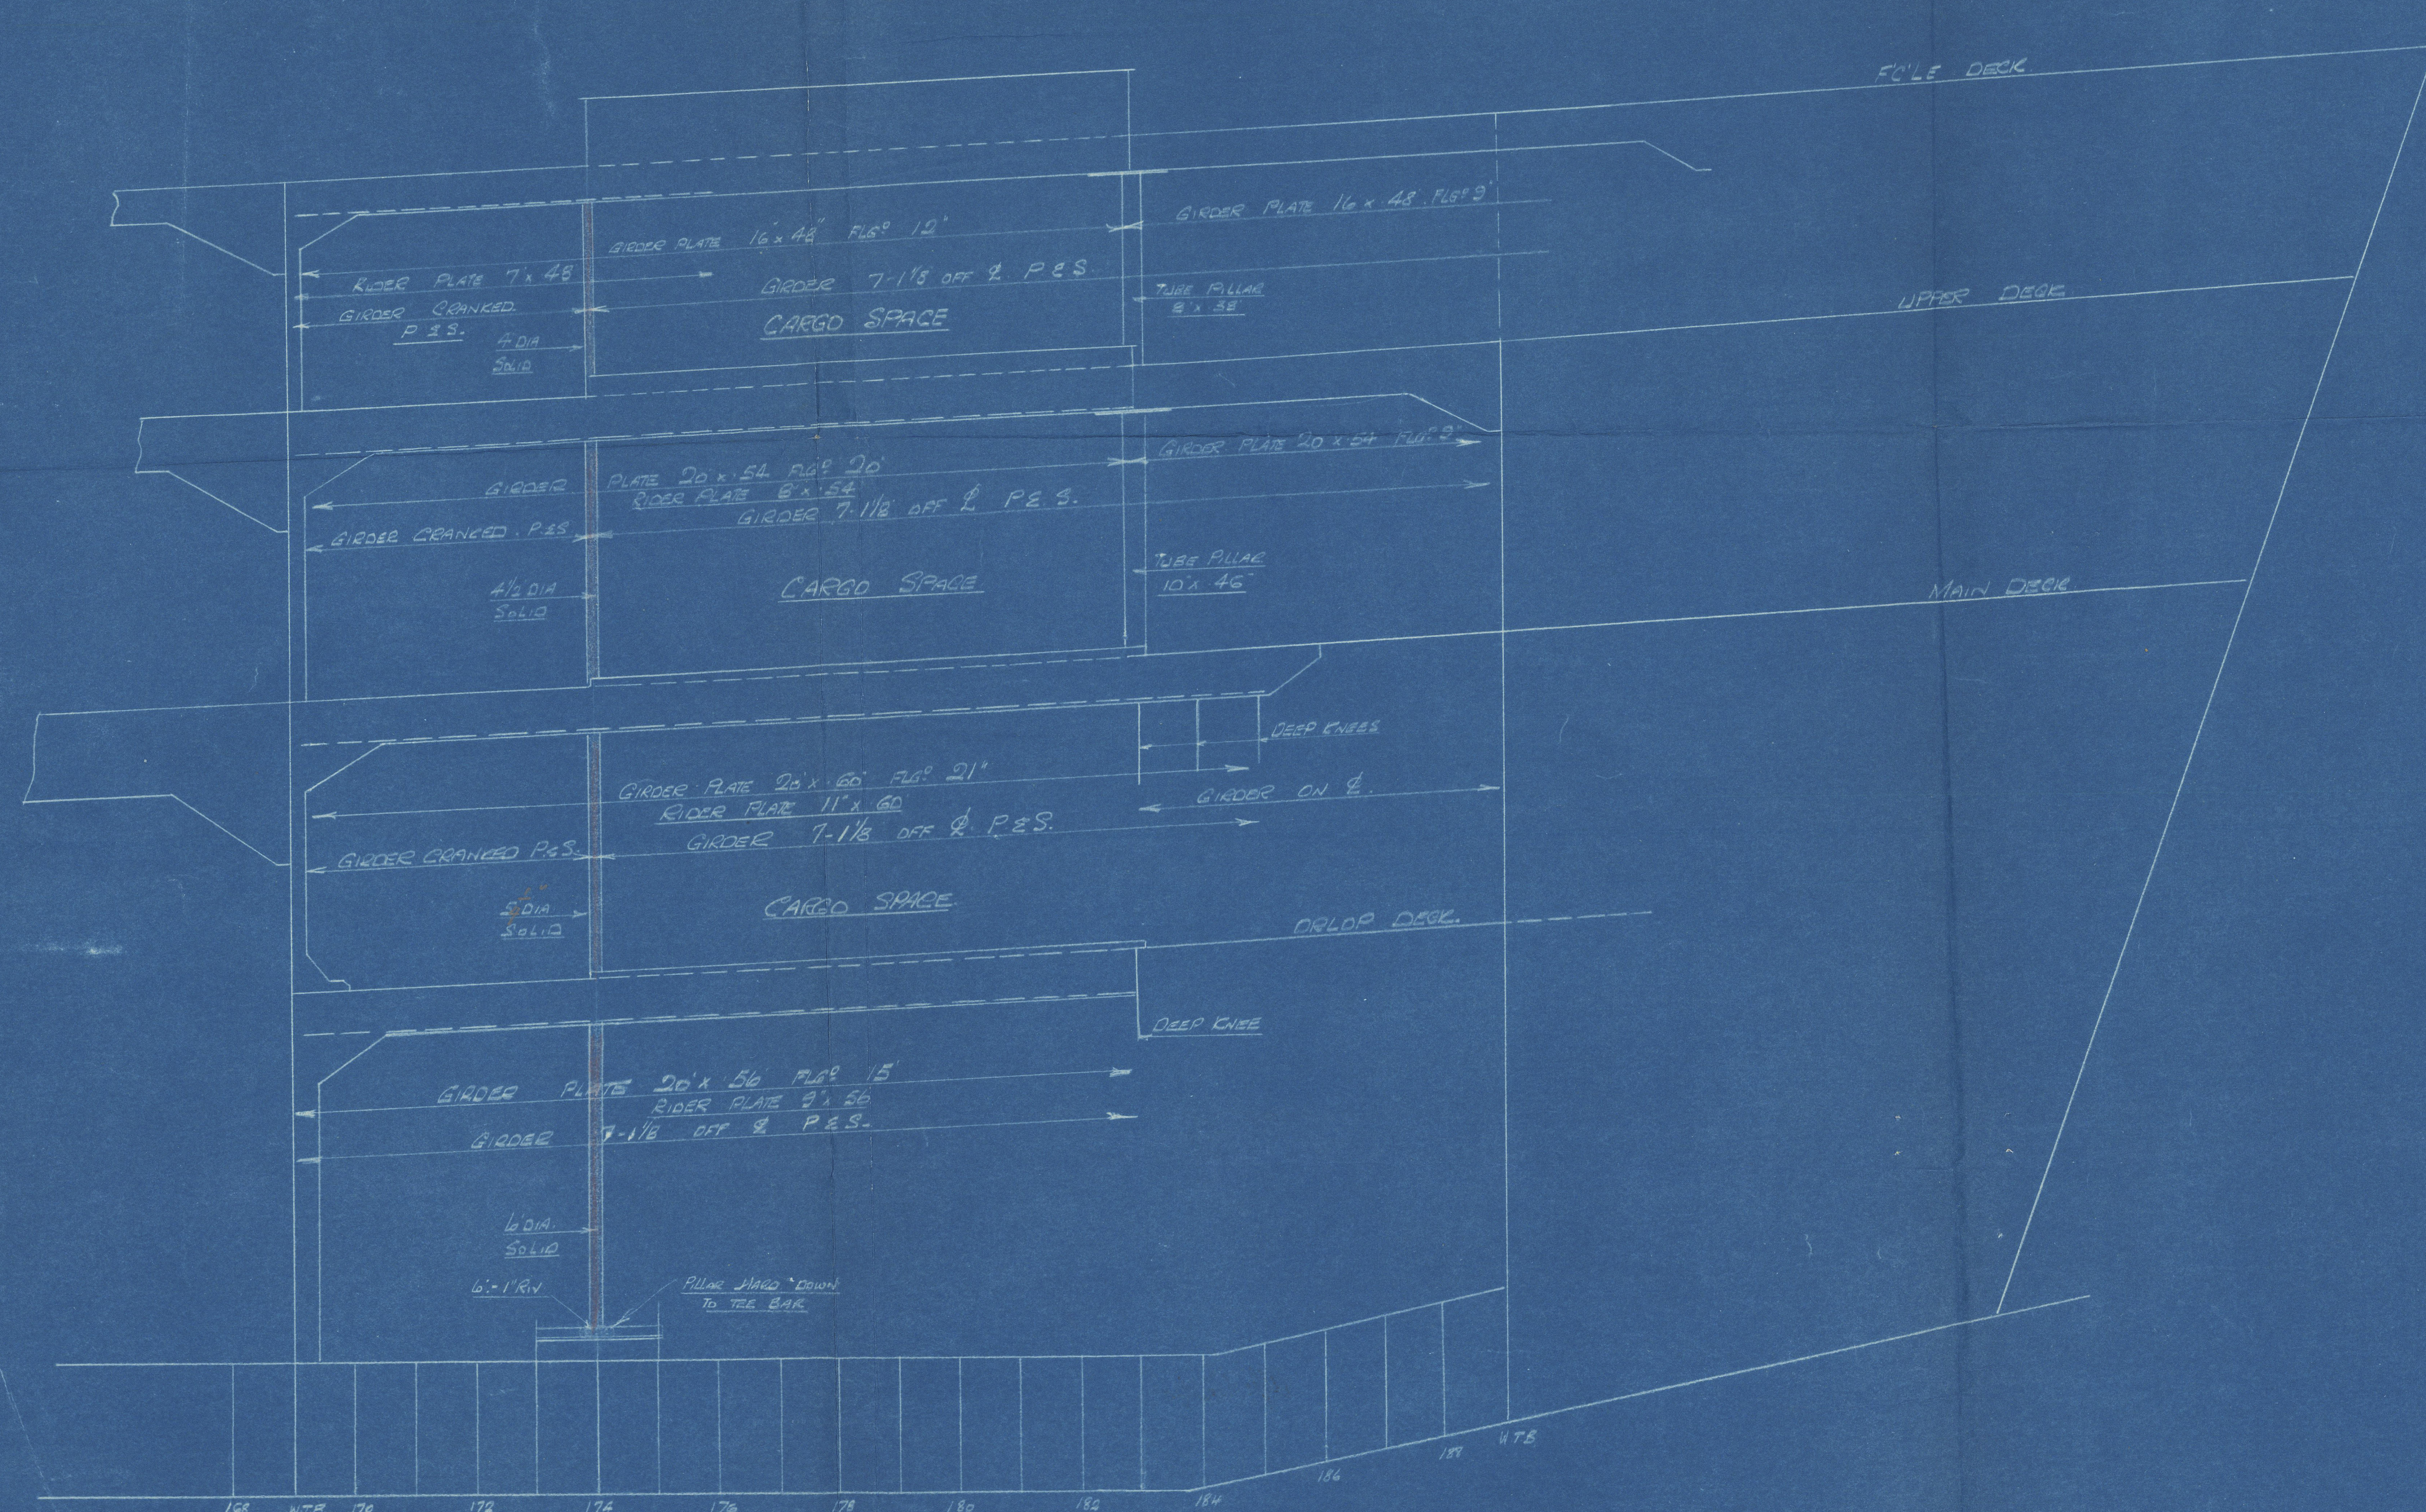

SECTION AT FRAME NO 174 LOOKING FORWARD.

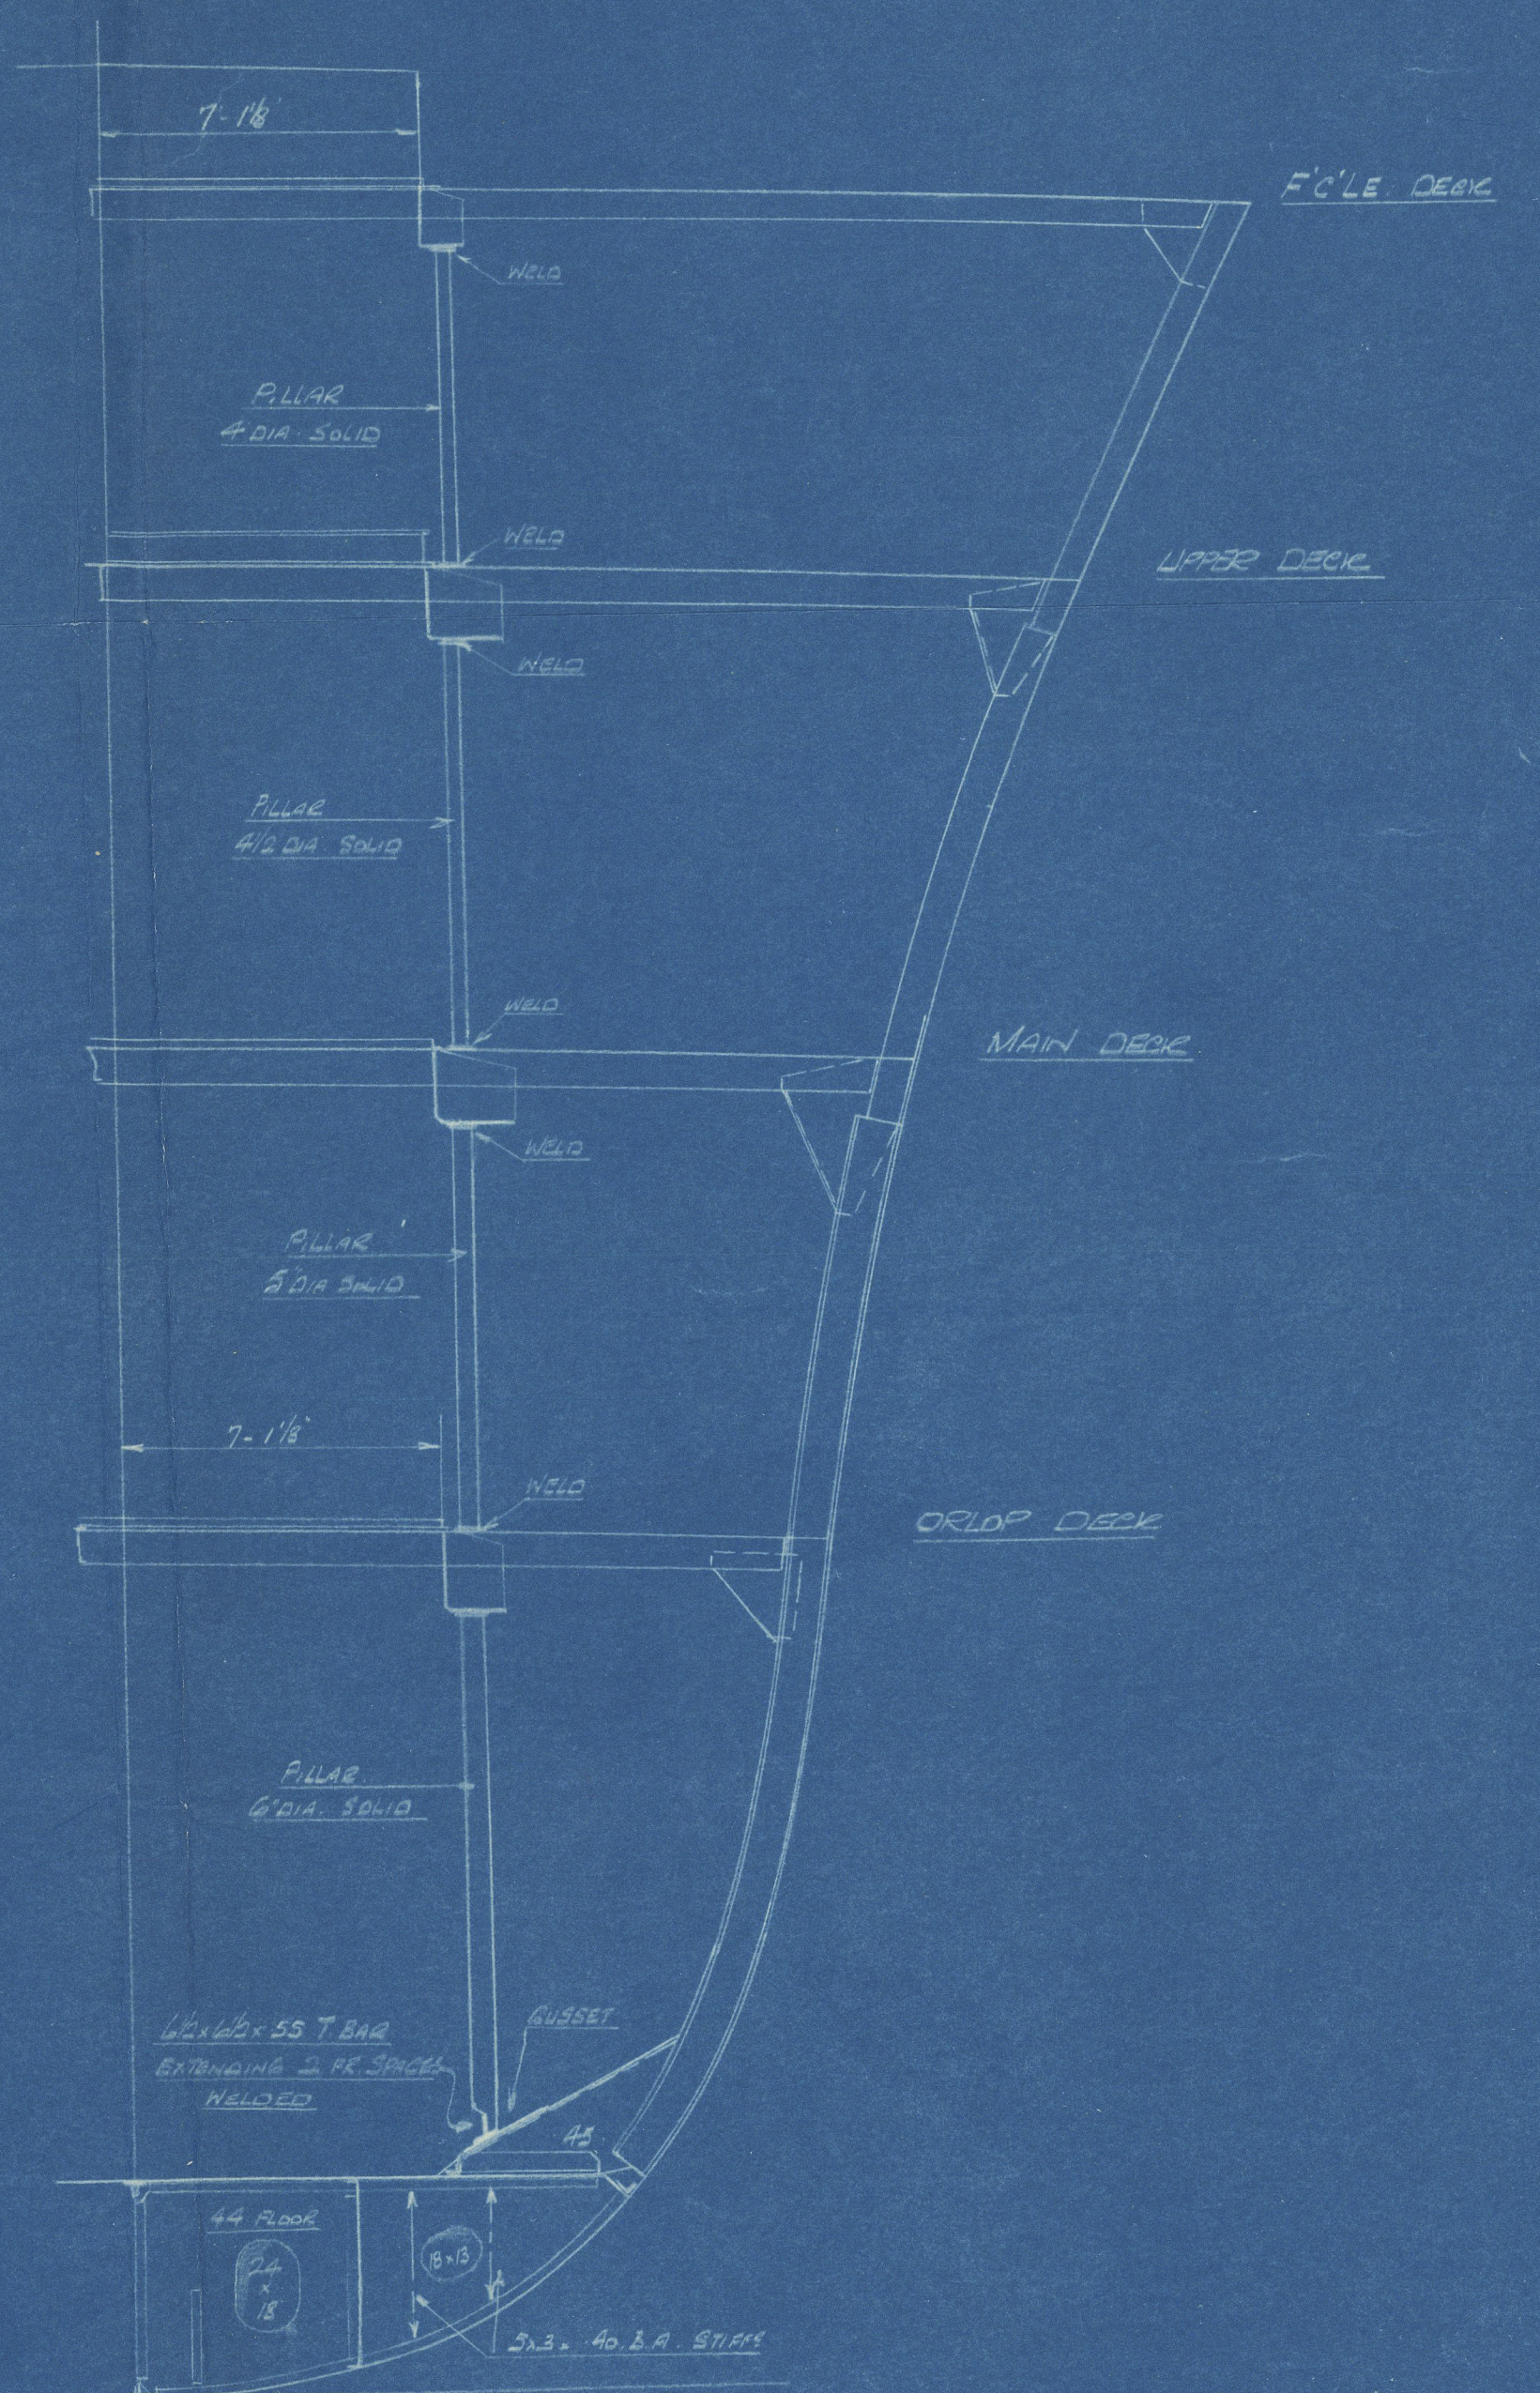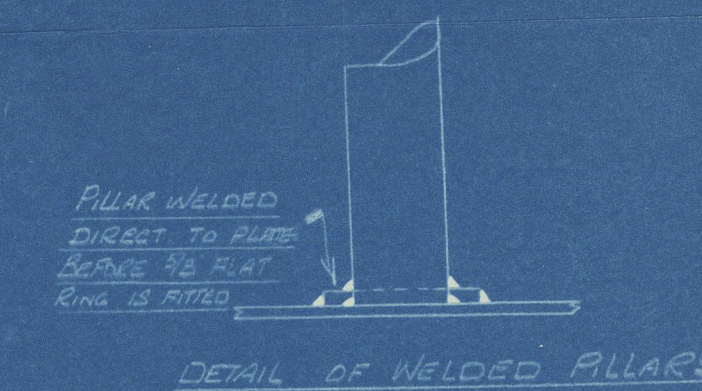

TN 302A
DRAWN BY
CHECKED BY

Cammell Laird & Co

Nº 1024

Midskip Section
(As built.)

S. S. City of Pretoria

LIVERPOOL

Report No. 110126

RETAIN



© 2020

Lloyd's Register
Foundation

RUDDER AND STERN FRAME

PLANS TRANSFERRED

TO SISTER VESSEL

8

CITY OF PRETORIA

Chamell Land Vess.

No. 1023+4, 1032+4

41046

Fly to Rudder
and sternframe

M/M. 1160

S. S. City of Capetown

LIVERPOOL

Report No. 109712

S. S. City of Pretoria

LIVERPOOL

Report No. 110126

S. S. City of Calcutta

LIVERPOOL

Report No. 114822

S. S.

LIVERPOOL

© 2020

Lloyd's Register

W1160-0140